
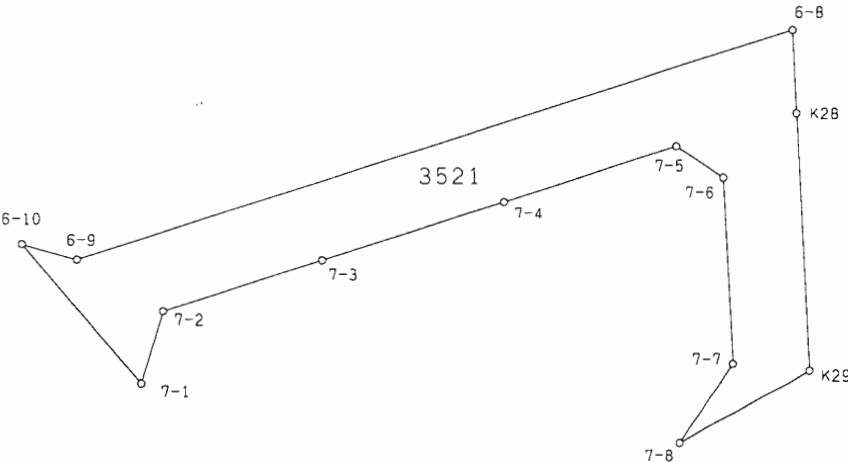


平成十六年六月

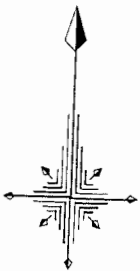

参考資料

※記載内容は換地処分当時のものです。 上尾市

画地面積計算書

現場名：上尾市中平塚区画整理地内

画地番号：3521

参考資料

※記載内容は換地処分当時のものです。上尾市

点名	X _n	Y _n	距離	方向角	測角	X _{n+1} - X _{n-1}	Y _{n+1} - Y _{n-1}	Y _n * (X _{n+1} - X _{n-1})	X _n * (Y _{n+1} - Y _{n-1})
6-10	-1599.735	-20347.832	9.693	137° 39' 58"	33° 47' 26"	-6.443	3.601	131101.081576	-5760.645735
7-1	-1606.901	-20341.304	3.979	14° 42' 03"	57° 02' 05"	-3.317	7.538	67472.105368	-12112.819738
7-2	-1603.052	-20340.294	8.780	70° 18' 08"	235° 36' 05"	6.808	9.276	-138476.721552	-14869.910352
7-3	-1600.093	-20332.028	10.048	70° 13' 30"	179° 55' 22"	6.358	17.721	-129271.034024	-28355.248053
7-4	-1596.694	-20322.573	9.608	70° 13' 25"	179° 59' 55"	6.650	18.496	-135145.110450	-29532.452224
7-5	-1593.443	-20313.532	3.011	121° 39' 31"	231° 26' 06"	1.671	11.604	-33943.911972	-18490.312572
7-6	-1595.023	-20310.969	9.891	175° 06' 28"	233° 26' 57"	-11.435	3.407	232255.930515	-5434.243361
7-7	-1604.878	-20310.125	5.022	212° 18' 19"	217° 11' 51"	-14.100	-1.840	286372.762500	2952.975520
7-8	-1609.123	-20312.809	7.827	59° 08' 12"	26° 49' 53"	-0.230	4.035	4671.946070	-6492.811305
K29	-1605.108	-20306.090	13.660	355° 06' 42"	115° 58' 30"	17.625	5.555	-357894.836250	-8916.374940
K28	-1591.498	-20307.254	4.449	355° 20' 22"	180° 13' 40"	18.045	-1.526	-366444.398430	2428.625948
6-8	-1587.063	-20307.616	39.622	250° 14' 28"	74° 54' 06"	-8.960	-37.651	181956.239360	59754.509013
6-9	-1600.458	-20344.905	3.014	283° 52' 32"	213° 38' 04"	-12.672	-40.216	257810.636160	64364.018928

倍面積	464.688871
面積	232.3444355
地積	232.34